

APPLICATION FOR PERMIT 3915-17  
COUNTY OF LOS ANGELES  
DEPARTMENT OF COUNTY ENGINEER  
BUILDING AND SAFETY DIVISION  
JOHN A. LAMBIE, County Engineer  
WILLIAM A. JENSEN, Sup't of Building

## SEWER-SEWAGE DISPOSAL

1

## FOR APPLICANT TO FILL IN

LEGAL DESCRIPTION	LOT NO. 250
BLOCK	TRACT 3840
SIZE OF LOT	NO. OF BLDGS. NOW ON LOT
USE OF BUILDINGS	Store
CONTRACTOR	John Washington
ADDRESS	737 E. 136 St
CITY	Los Angeles TEL. NO. FA 11021
REGISTRATION NO. 220148	<input checked="" type="checkbox"/> STATE COUNTY

NO.	DESCRIPTION OF WORK	FEE		
	HOUSE SEWER CONNECTING TO PUBLIC SEWER	@ \$5.00		
	SEPTIC TANK, SEEPAGE PIT OR PITS AND/OR DRAINFIELD	@ \$10.00		
	HOUSE SEWER CONNECTING TO PRIVATE DISPOSAL SYSTEM	@ \$3.00		
1	CONNECT ADDITIONAL BLDG. OR WORK TO HOUSE SEWER	@ \$3.00	3	00
	OVERFLOW SEEPAGE PIT, DRAINFIELD EXTN., CESSPOOL, DRYWELL, MANHOLE	@ \$5.00		
	ALTER, REPAIR OR ABANDON HOUSE SEWER OR DISPOSAL SYSTEM	@ \$3.00		

OWNER'S AUTHORIZATION	PERMIT \$ 2 00
	TOTAL FEE 5 00

I HAVE AT THIS DATE A CONTRACT WITH THE HEREIN NAMED CONTRACTOR TO CONNECT THE ABOVE DESCRIBED EXISTING DWELLING TO THE PUBLIC SEWER.

SIGNED THIS \_\_\_\_\_ DAY OF \_\_\_\_\_ 19\_\_\_\_

OWNER OR OWNERS AGENT \_\_\_\_\_

ADDRESS \_\_\_\_\_

I HEREBY ACKNOWLEDGE THAT I HAVE READ THIS APPLICATION AND STATE THAT THE ABOVE IS CORRECT AND AGREE TO COMPLY WITH ALL COUNTY ORDINANCES AND STATE LAWS REGULATING PLUMBING AND SEWERS.

I HEREBY CERTIFY THAT I AM PROPERLY REGISTERED AND/OR LICENSED AS REQUIRED BY LOS ANGELES COUNTY AND STATE OF CALIFORNIA OR THAT I AM THE LEGAL OWNER OF, AND INTEND TO RESIDE IN, THE ABOVE DESCRIBED RESIDENTIAL PROPERTY.

SIGNATURE OF PERMITTEE John Washington

BUILDING ADDRESS	3915 Union Pacific Ave.		
LOCALITY			
NEAREST CROSS ST.	Indiana St		
OWNER	Amelia Marovich		
MAIL ADDRESS	400 W Alameda		
CITY	Montebello TEL. NO. 269-7658		
DISTRICT NO.	GROUP	MAP BK PG	PROCESSED BY
6	F	F 55	Bellomy
CONNECTION DATA			
STATION 1+94		DEPTH 3+37 E	
MANHOLE REFERENCE 143 E W		UPPER LOWER	
TYPE OF CONNECTION Y. CURB		LENGTH FROM M.L. TO P.L.	
CO. IMP. NO. 566		P.C. NO. JOB NO. 51846	
TRUNK PERMIT NO.		ROAD PERMIT NO.	
AFFIDAVIT	WAIVER	EASEMENT	RECORD. INSTR. NO. DATE
HWY. OR ST. WIDENING			
STATE ENCROACHMENT PERMIT NO.			
INDUSTRIAL WASTE APPROVAL			
CHARGES			
CONNECTION CHARGE FEE			
REIMBURSEMENT FEE			
APPROVALS		DATE	INSPECTOR'S SIGNATURE
NEW HOUSE SEWER			
CONNECT ADDITIONAL BUILDING OR WORK		1-19-46	Hammer
SEPTIC TANK, SEEP, PIT(S) AND/OR DRAINFIELD			
CESSPOOL <input type="checkbox"/> DRYWELL <input type="checkbox"/>			
ALTER, REPAIR, SEWER OR SEWAGE DISPOSAL SYSTEM			
DISCONNECT PLUG AND ABANDON HOUSE SEWER			
BACKFILL SEPTIC TANKS <input type="checkbox"/> SEEP, PIT(S) <input type="checkbox"/> CESSPOOLS <input type="checkbox"/>			

VALIDATION 10.00

ROBERT A. WOOD

CK.

M. O.

CASH

SUPERVISING MECHANICAL ENGINEER

LAC 000493 JAN 19 1946

5.00 55


Bellomy

INSPECTOR COPY

# FOR DEPARTMENT USE

## REQUIRED INFORMATION

1. INDICATE ALL BUILDINGS ON PROPERTY.
2. INDICATE AND DIMENSION SEWAGE DISPOSAL SYSTEM WITH TIE DISTANCES TO BUILDINGS AND PROPERTY LINES.
3. INDICATE SIZE OF SEPTIC TANK—DEPTH OF SEEPAGE PIT(S)—SIZE OF CESSPOOL(S).
4. INDICATE NORTH DIRECTION ON PLOT.
5. INDICATE BOTH STREETS IF CORNER.

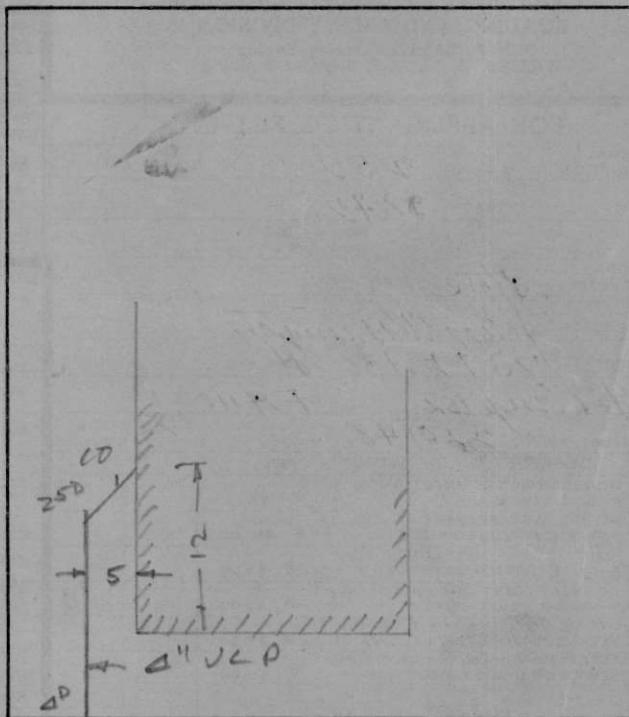

ST. ALLEY R/W

FIELD NOTES